

REQUEST FOR PROPOSAL

Project Title: Cooley Laboratory Renovation
Location: Montana State University

PPA No.: 10-0023
RFP No.: 100
Date: February 14, 2013

To: Dick Anderson Construction
4498 Jackrabbit Lane
Bozeman, MT 59718

Attention: Platisha

From: Cecilia Vaniman, Project Manager
Cooley Lab Renovation
Montana State University

Attention: _____

In order to expedite the Work and avoid or minimize delays in the Work the following information is requested. Please return a response by: 02/22/2013 Date Sent: 02/15/2013
Date Received: _____

Proposal Requested:

Provide intermediate plywood shelving at 3 custom tables

Scope of work includes; Division 05 – 06 - & 11

Please provide the following shelving as described;

For each of the 3 tables described

- ¾ “ AC Plywood with Chem surf laminate on all sides (Top –bottom and edges)
- 2 - 1 ½” X 1 ½” angle supports at each end bolted to existing custom table. (See Attached drawing)

This RFP is for pricing purposes only. The contractor shall not proceed with the scope of work described within until pricing is approved by the owner in writing.


Distribution: Owner Architect Engineer
 Agency Contractor Other

- NO EXCEPTION
- MAKE CORRECTIONS NOTED
- REJECTED
- REVISE & RESUBMIT
- SUBMIT SPECIFIED ITEM

Checking is only for general conformance with the design concept of the Project and general compliance with the information given in the Contract Documents. Any action shown is subject to the requirements of the plans and specifications. Contractor is responsible for: dimensions which shall be confirmed and correlated at the job site; quantities; information that pertain to the fabrication process and techniques of construction; coordination of this work with that of all other trades, and the satisfactory performance of the Contractor's work.

John Summers Date **11-1-2012**

MONTANA STATE UNIVERSITY
Office of Facilities Services
Facilities Planning & Management

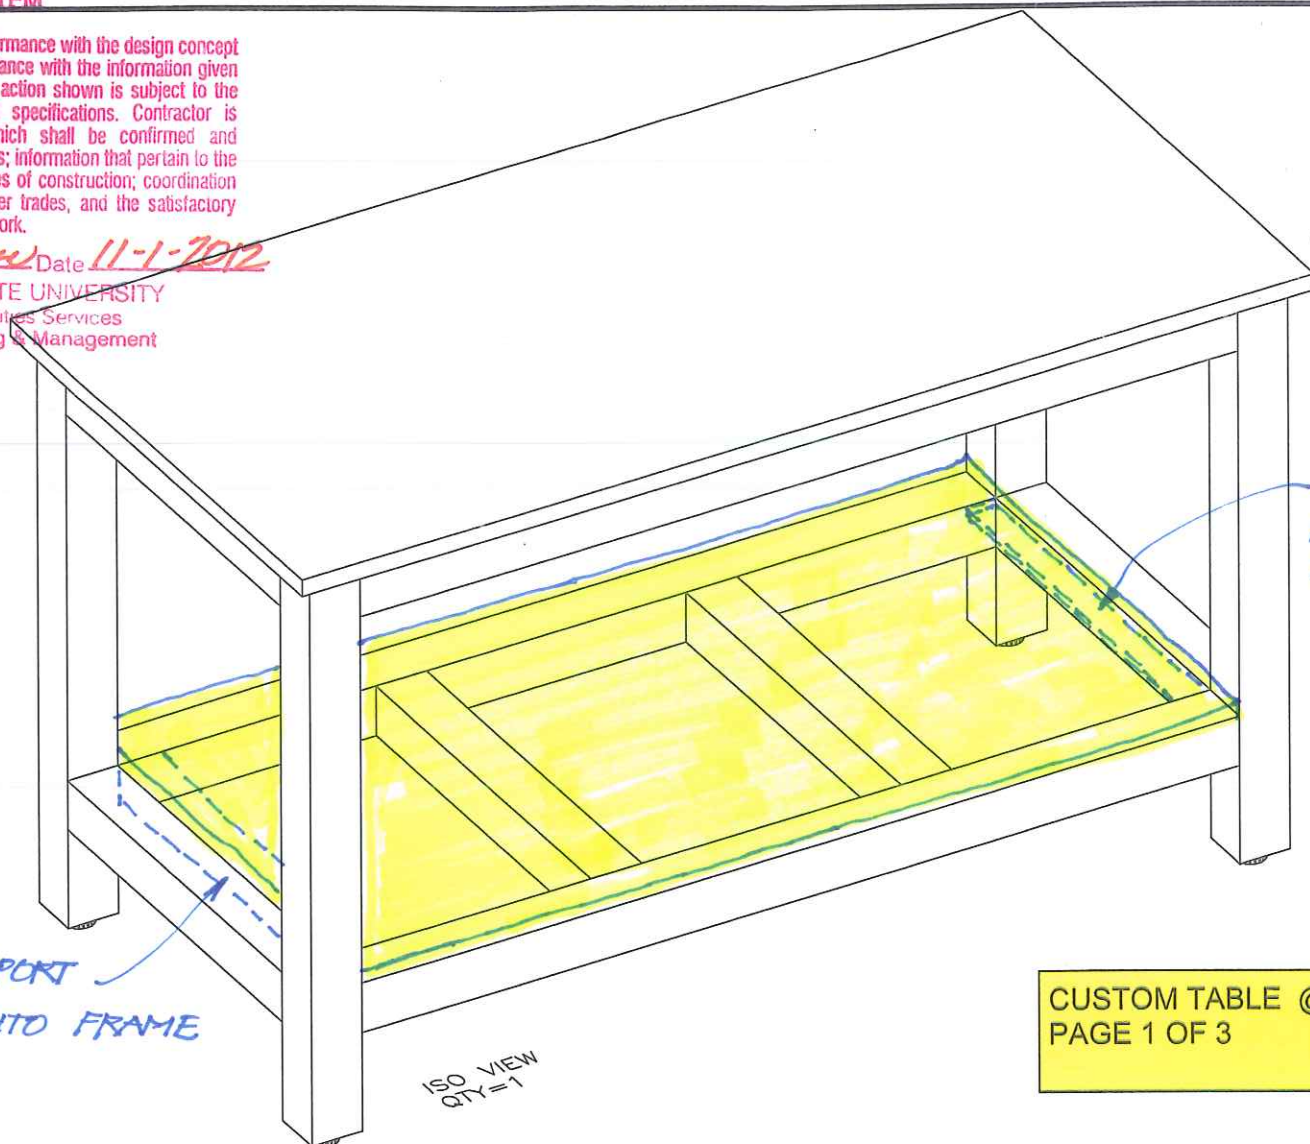

Δ SUPPORT
BOLT INTO
FRAME

Δ SUPPORT
BOLT INTO FRAME

CUSTOM TABLE @ ROOM 428
PAGE 1 OF 3

ISO VIEW
QTY=1

PROJECT ISEC MSU COOLY	SHEET TITLE MED TABLES ISO VIEW	DATE 10/25/2012	SCALE 1=4	DRAWN BY J.T.W.	CONTRACT# 91-05??		
		MATERIAL 11 GA.			REQUIRED: NOV15	B#	SHEET 1 of 3
		FINISH GLACIER BLUE					DWG# 01