

#### FACILITIES PLANNING, DESIGN & CONSTRUCTION

Sixth Avenue and Grant Street • P.O. Box 172760 • Bozeman, Montana 59717-2760 Phone: (406) 994-5413 • Fax: (406) 994-5665

	R	REQUEST FOR PROP	OSAL	
Project Ti Location:	tle: <u>Cooley Laboratory R</u> <u>Montana State Unive</u>		PPA No.: RFP No.: Date:	10-0023 35 02/20/12
To:		ction	Attention:	<u>Platisha</u>
	4498 Jackrabbit Lane Bozeman, MT 59718			
From:	Cecilia Vaniman, Proje Cooley Lab Renovation Montana State Universi		Attention:	
		minimize delays in the Work the ern a response by: 03/01/2012		nt: <u>02/20/2012</u>
Proposal Requested	1:			
Davisa Cas	owerk A 20 T	one from Dlem to Eneve		
•		ops from Plam to Epox pinets revise to Mobile	<del></del>	Enaxy ton
				<del></del>
<u>Drawing</u>		ving Sheet QL3.1 Detail 2 & 4 A-		abmet
Specification Se	ction 12345 Labora	atory Casework and Work Surfac	es	
Revise t match	he A-30 Type Base (	Cabinet; replace PLam top Blac	k with Epoxy Resin Top	Color Black to
2. Revise t	he B-30 Type Base (	Cabinet to be a Mobile Cabinet	(A-30)	
3. Add Epo	xy Resin Top Color	Black to match.		
,	,			
	ricing purposes only. The owner in writing.	ne contractor shall not proceed with	the scope of work describe	ed within until pricing
Distribution: [	Owner Agency	<ul><li>✓ Architect</li><li>✓ Contractor</li></ul>	Engineer Other	

#### WATER FIXTURE/FITTING SCHEDULE

#### SEE SPECIFICATION SECTION 11604

TAG	HCW	PW	PRE	EW	REMARKS	NOTES
F1	HCW1	PW1		EW1		1
F2	HCW2	PW1		EW1	W/ WRIST BLADES	2
F3		PW2			MOUNT AT 96" A.F.F.	3
F4	HCW3		PRE1		AT SCULLERY SINK	
F5				EW2	AT AUTOCLAVE ROOM	

<u>NOTES</u>

1. SEE DETAIL, 15/QL4.1

2. SEE DETAIL, 20/QL4.1 FOR ADA STATION

3. SEE DETAIL, 1/QL3.2

# SINK SCHEDULE

#### SEE SPECIFICATION SECTION 11604

TAG	SINK MAT'L	DIM	MENSIONS	(IN.)	# OF	MOUNTING TYPE	NOTES	
		А	В	DEPTH	BOWLS	REMARKS		
	S1	EPOXY	21	17	10	1	LIPPED	1
	S2	EPOXY	18	15	6	1	LIPPED	1
	<b>S</b> 3	EPOXY	6	14.5	6	1	LIPPED	1, 2
	S4	S.S.	15	24	14	2	LIPPED	3

<u>NOTES</u>

1. SEE DETAIL, 17/QL4.1

2. EWA CUP SINK

3. S.S. SCULLERY SINK. OVERALL LENGTH IS 72" X 27.5" DEEP.

FRONT OF CASEWORK SINK PLAN

# GAS, AIR & VAC FITTING SCHEDULE

#### **SEE SPECIFICATION SECTION 11604**

TAG	GAS	AIR	VAC	REMARKS	NOTES
F10	G1			DECK MOUNTED, 180°	

GAS VALVES THAT ARE A PART OF THE MOBILE CASEWORK SYSTEM ARE PART OF SPEC SECTION 12345, 2.6, E. "MOBILE CASEWORK SYSTEM".

# GROUP 1 EQUIPMENT SCHEDULE

#### SEE SPECIFICATION SECTION 11605

TAG	DESCRIPTION	NOTES
(EQ1)	EMERGENCY SHOWER	1
(EQ2)	NON-VENTED FLAMMABLE STORAGE CABINET "SciMatCo" OR EQUAL	PROVIDE 5 EACH
(EQ3)	ICE MACHINE	3
(EQ4)	STEAM GENERATOR	3
(EQ5)	GLASSWASHER	3
(EQ6)	20x20x38" AUTOCLAVE W/ INTEGRAL CLEAN STEAM GENERATOR	3
(EQ7)	26x37.5x38 AUTOCLAVE (REQUIRES STEAM FROM EQ4)	3
(EQ8)	OVEN W/ S.S. ENCLOSURE	2
(EQ9)	WATER POLISHER	
(EQ10)	KODAK X-OMAT 2000	
(EQ11)	LASER CURTAIN	

<u>NOTES</u>

1. SEE DETAIL 1/QL4.1

2. FINAL CONNECTIONS BY DIV. 15.

3. FINAL CONNECTIONS BY DIV. 15 AND 16.


#### CASEWORK SCHEDULE

**SEE SPECIFICATION SECTION 12345** 


# CASEWORK LEGEND

CABINET TYPE - A ------I CABINET WIDTH - 30 ----LOCKABLE – L ———


#### KNEE SPACES

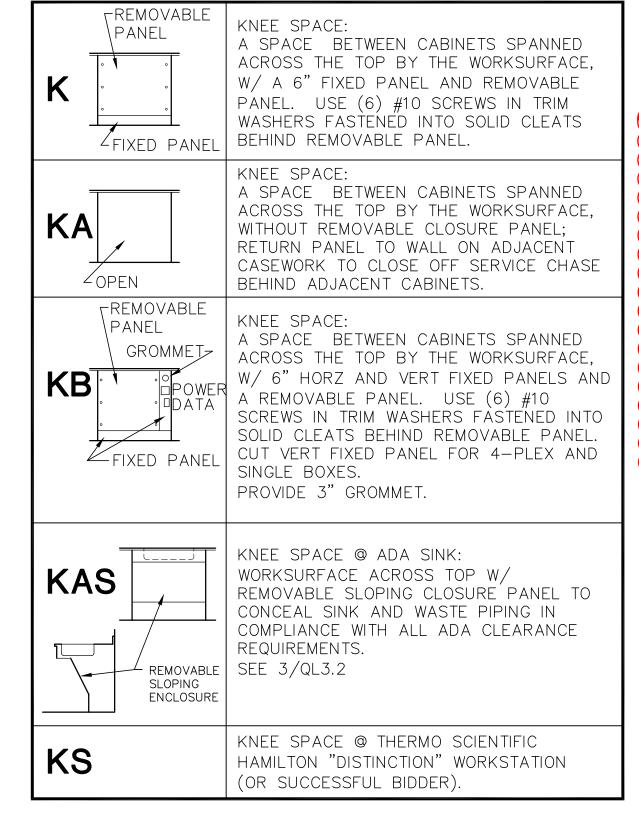

#### SHELVING

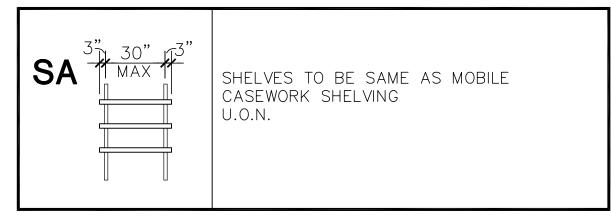

#### **PEGBOARD**

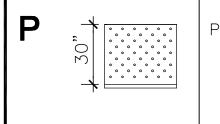

PEGBOARD W/ DRIP TROUGH.

#### HOOD SCHEDULE

#### SEE SPECIFICATION SECTION 11601

TAG	SIZE/DESCR	TYPE	UTILITIES	NOTES				
		SEE SPEC	UTILITIES 110v DUPLEX	GAS	AIR	CS/CWA		
H <sub>1</sub>	4'-0" FUME HOOD	FH-A	L/R	L		R		
H 2	4'-0" FUME HOOD	FH-B	L/R	L		R	1	
H 3	6'-0" BIOSAFETY CABINET	BSC-A	L/R	L/R			2, 3	
NOTES		_						

1. SEE DETAIL 3/QL4.1 FOR ACCESSIBLE FUME HOOD

2. ALL BIOSAFETY CABINETS ARE "ACCESSIBLE" WITH THE

ADJUSTABLE STAND.

3. NATURAL GAS FIXTURES ARE NOT CONNECTED TO HOUSE GAS.

# CASEWORK NOTES

TOP WITH EPOXY

MOBILE CABINET WITH PLAM TOP (BLACK):

THERMO SCIENTIFIC HAMILTON "DISTINCTION

HINGED DOOR, SINGLE CUPBOARD W/ AN

APRON STRIP (6" NOM. HIGH, FLUSH W/

SINGLE CUPBOARD, NO SHELVES UP UNIT I

LESS THAN 30" WIDE, PROVIDE SINGLE DOO

DOOR FRONT), HINGED DOUBLE DOORS,

SINGLE CUPBOARD W/ AN ADJUSTABLE

PROVIDE SINGLE DRAWER AND DOOR.

SHELF. IF UNIT IS LESS THAN 30" WIDE,

/ENTED CORROSIVE STORAGE LINED CABINET

SINGLE CUPBOARD W/ 1" DEEP TRAY AND

THERMO SCIENTIFIC HAMILTON "DISTINCTION

(2) BOTTOM DRAWER UNITS - 9" HIGH,

RESIN TOP

(2) TOP DRAWER UNITS - 3" HIGH,

RELOCATABLE COMBINATION CABINET:

ALL OTHER DRAWERS ARE EQUAL,

MIDDLE DRAWERS ARE EQUAL

FOP DRAWER IS 6" HIGH,

ADJUSTABLE SHELF.

SINK BASE CABINET:

COMBINATION CABINET:

HINGED DOUBLE DOORS,

AN ADJUSTABLE SHELF.

SEE SPEC 11601

VENT TO ADJACENT FUME HOOD.

WELDED METAL TABLE BASE

30" WIDE EPOXY RESIN TOP.

W/ ADJUSTABLE LEGS.

(2) DRAWERS (6" NOM. HIGH);

BASE CABINETS

B

MOBILE CABINET

WITH EPOXY

**TABLES** 

RESIN TOP

- CASEWORK IS FLOOR MOUNTED (FIXED) WOOD CASEWORK WITH WOOD VENEER AT WALLS AND METAL CASEWORK ON CASTERS WITH WOOD VENEER FRONTS AT PENINSULA BENCHES. U.O.N.
- 2. CASEWORK DIMENSIONS INDICATED ON PLANS ARE NOMINAL SIZES. HEIGHT OF BASE CABINETS REFERS TO HEIGHT OF FINISHED BENCHTOP. SIZE CASEWORK HEIGHT TO ACHIEVE THIS DIMENSION. NO CASEWORK UNIT SHALL BE LESS THAN
- USE FILLER PANELS, AS REQUIRED, FOR GAPS BETWEEN WALLS, CASEWORK, AT CORNER CONDITIONS, AT EXPOSED ENDS BETWEEN WALLS AND CASEWORK UNITS AND AT ALL OTHER AREAS TO PROVIDE FINISHED ASSEMBLY.
- HINGE SIDE OF SWINGING DOORS SHALL BE TOWARDS BENCH END WHEN THE CABINET IS AT THE END OF THE BENCH. HINGE SIDE SHALL BE AT THE CORNER WHEN THE CABINET IS AT A CORNER CONDITION. THE HINGE MAY BE AT EITHER SIDE WHEN THE CABINET IS NOT AT AN END OR CORNER, UNLESS SWING IS NOTED ON PLANS.
- 5. SINKS SHALL BE CENTERED (FROM SIDE TO SIDE) IN SINK BASE CABINETS, U.O.N.
- PROVIDE REMOVABLE BACKPANELS IN ALL DOOR CABINETS. PROVIDE FIXED PANELS AT BACKS OF DRAWER UNITS. PROVIDE HALF BACKS AT SINK CABINETS.
- 7. WHERE THE TERM "REMOVABLE" IS USED, (6) FASTENERS TO BE SCREWS WITH CUPPED TRIM WASHERS, U.O.N.
- WHERE SCREWS ARE USED TO MOUNT SUPPORT BRACKETS FOR SHELVING, SCREW COLOR WILL MATCH SUPPORTS.
- 9. THE NAME "THERMO SCIENTIFIC HAMILTON" AND THE TRADEMARK "DISTINCTION" IS USED ONLY TO IDENTIFY THE MOBILE CASEWORK FOR THIS PROJECT AND IS NOT MEANT TO INDICATE THE ULTIMATE MANUFACTURER USED.

# WORKSURFACE NOTES

- PROVIDE SIDE SPLASH WHERE BENCH END ABUTS WALL, FUME HOOD OR FULL HEIGHT CABINET, OR WHERE COUNTERTOPS WITH DIFFERENT HEIGHTS ABUT EACH OTHER.
- 2. KEEP TOP OF SPLASH AT 40" A.F.F. NOM. EVEN WHEN 34" HIGH CASEWORK UNITS ARE ADJACENT TO 36" HIGH CASEWORK UNITS.
- 3. BACK AND SIDE SPLASHES ARE TYPICALLY 4" HIGH AT 36" HIGH WORKSURFACES.
- WORKSURFACES ARE TO OVERHANG 1" AT THE FRONT EDGE OF THE CASEWORK (TYP.), WITH DRIP EDGE. WORKSURFACES OVERHANG SIDE OF CABINET 1" AT END OF BENCH RUNS (TYP.)
- 5. PROVIDE SILICONE SEALANT AT ALL JOINTS BETWEEN WORKSURFACES AND WHERE WORKSURFACES ABUT WALLS AND VERTICAL UPRIGHTS.
- 6. ALL WORKSURFACES ARE EPOXY RESIN U.O.N. BENCHES SHALL BE 30" DEEP (INCLUDING SPLASH) AND NOMINALLY 36" HIGH U.O.N.
- 7. SHADING ON PLAN DENOTES ACCESSIBLE SINKS, WORKSTATIONS AND FUME HOODS.
- 8. SEAL ALL INTERFACES BETWEEN CABINETS, COUNTERTOPS, FUME HOODS AND WALLS WITH 100% CLEAR SILICONE EXCEPT ACCESS PANEL (IF ANY).

# **ACCESSIBILITY NOTES**

- 1. ACCESSIBLE FUME HOODS, SINKS, AND WORKSTATIONS ARE SHOWN SHADED ON PLANS (34" HIGH WORKSURFACE MAX. AND 30" WIDE  $\times$  27" HIGH  $\times$  17" DEEP KNEE SPACE MIN.).
- 2. ALL EMERGENCY/SHOWER EYEWASH UNITS ARE ACCESSIBLE.






# enovati

Montana C



DRAWN BY: GB CHECKED BY: MO APPROVED BY: NW | REV DESCRIPTION | DATE

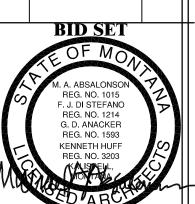



**SCHEDULES** 

March 14, 2011