



## FACILITIES PLANNING, DESIGN & CONSTRUCTION


Sixth Avenue and Grant Street • P.O. Box 172760 • Bozeman, Montana 59717-2760 Phone: (406) 994-5413 • Fax: (406) 994-5665

REQUEST FOR PROPOSAL			
Project Ti	le: Cooley Laboratory Renovation		PPA No.: 10-0023
Location:	Montana State University	<del></del>	RFP No.: 92 R
Location.	Womana State University	<del></del>	Date: January 22, 2013
			Feb 1, 2013
To:	Dick Anderson Construction		Attention: <u>Platisha</u>
	4498 Jackrabbit Lane	<u> </u>	
	Bozeman, MT 59718		
From:	Cecilia Vaniman, Project Manager		Attention:
Trom.	Cooley Lab Renovation	<del></del>	
	Montana State University		
	·		
	the Work and avoid or minimize delays on is requested. Please return a response		Date Sent: <u>01/22/2013</u> Date Received:
Proposal Requested:			
BLACK OUT CURTAINS			
Scope of work includes; Division 12 Black Out Curtains			
<ul> <li>Phifer SheerWeave 7100, Color PO471 White/Bone for the fabric. COLOR WHITE</li> <li>Rails and Fascia to be "Clear Anodized"</li> </ul>			
Refer to floor plans for locations (9)			
SEE ATTACHED Sheets RFP92-1 through RFP92-3			
This RFP is for pricing purposes only. The contractor shall not proceed with the scope of work described within until pricing is approved by the owner in writing.			
Distribution:	Owner A	rchitect	Engineer
		Contractor	Other
_			

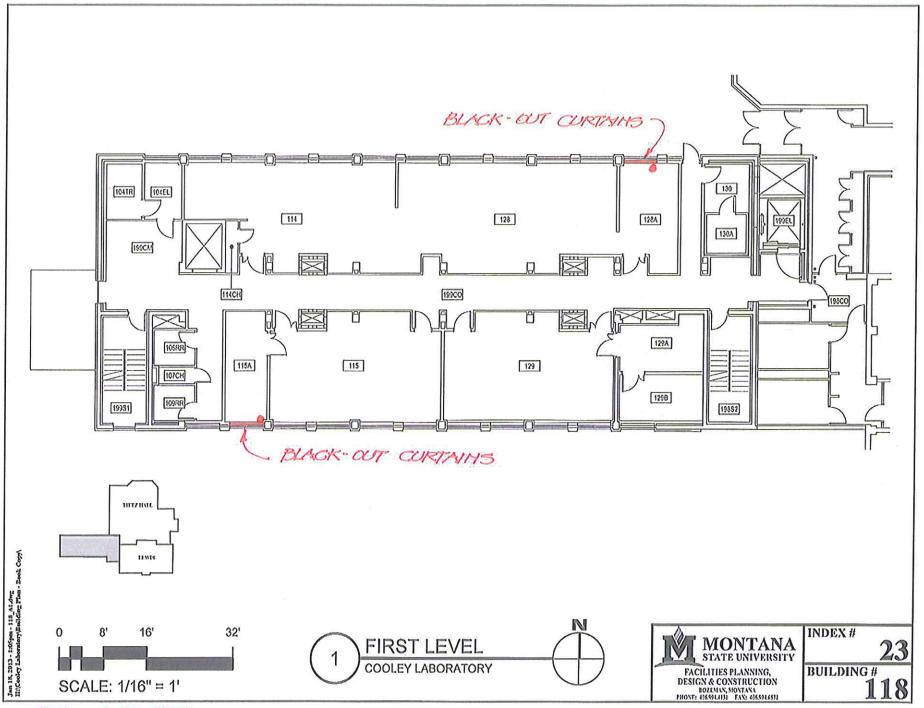

CRV 1-22-2013

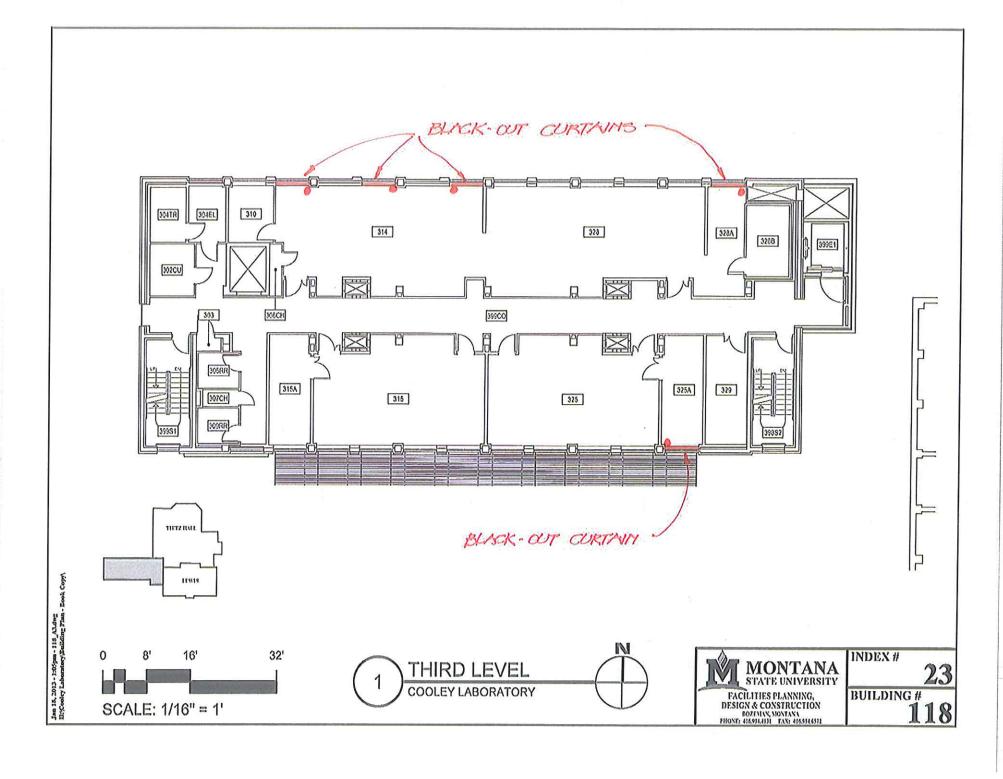

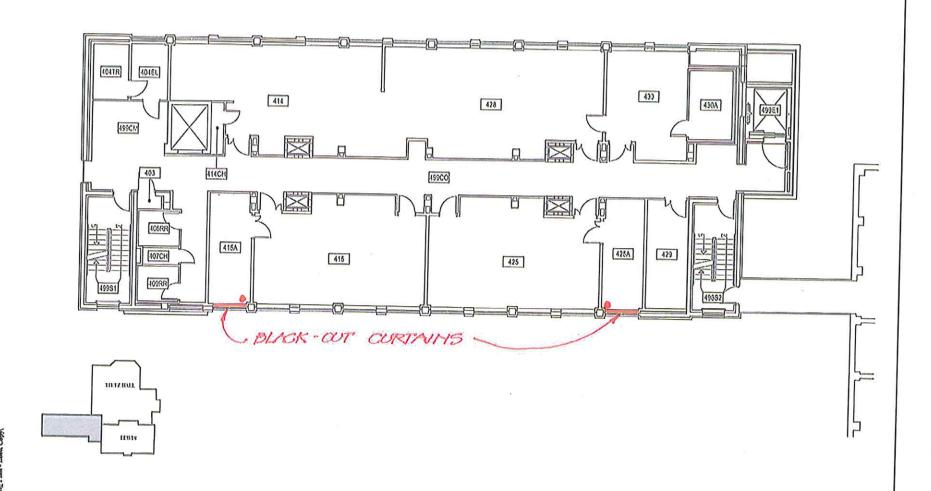

FOURTH LEVEL

COOLEY LABORATORY

INDEX#

BUILDING # 118

23

MONTANA STATE UNIVERSITY

FACILITIES PLANNING,
DESIGN & CONSTRUCTION
BOJENIN, NOVIAN
PRONE HASPLINE FAN HASPLENE

Jan 13, 2013 - 1305pm - 113, Address

32'

16'

SCALE: 1/16" = 1'