
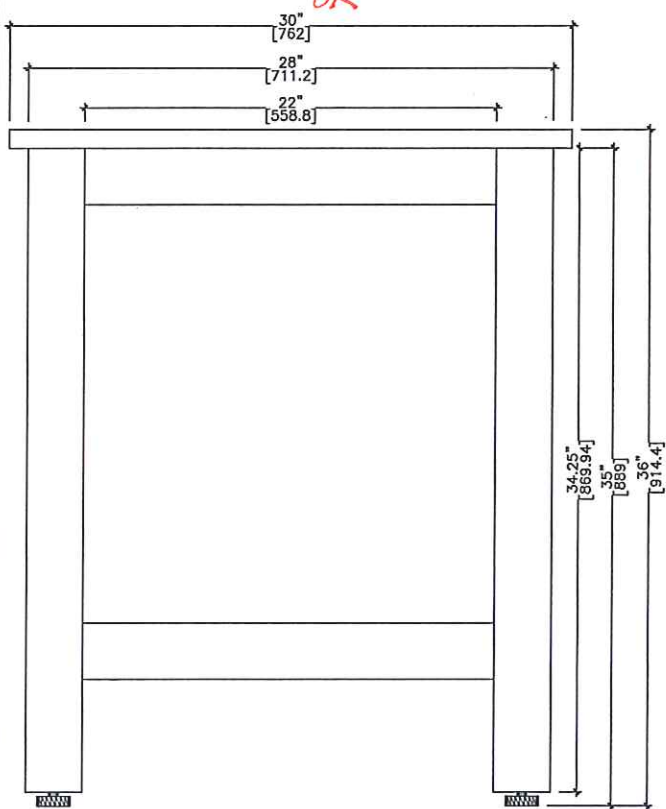


C:\Users\jtd\Documents\Local Settings\Temporary Internet Files\Content.IE5\kxv1d4\77mrry_04y\table.dwg, ISEC MID TABLE, 10/25/2012 4:52:24 PM

RESIN TOP BY OTHERS

OK

OK

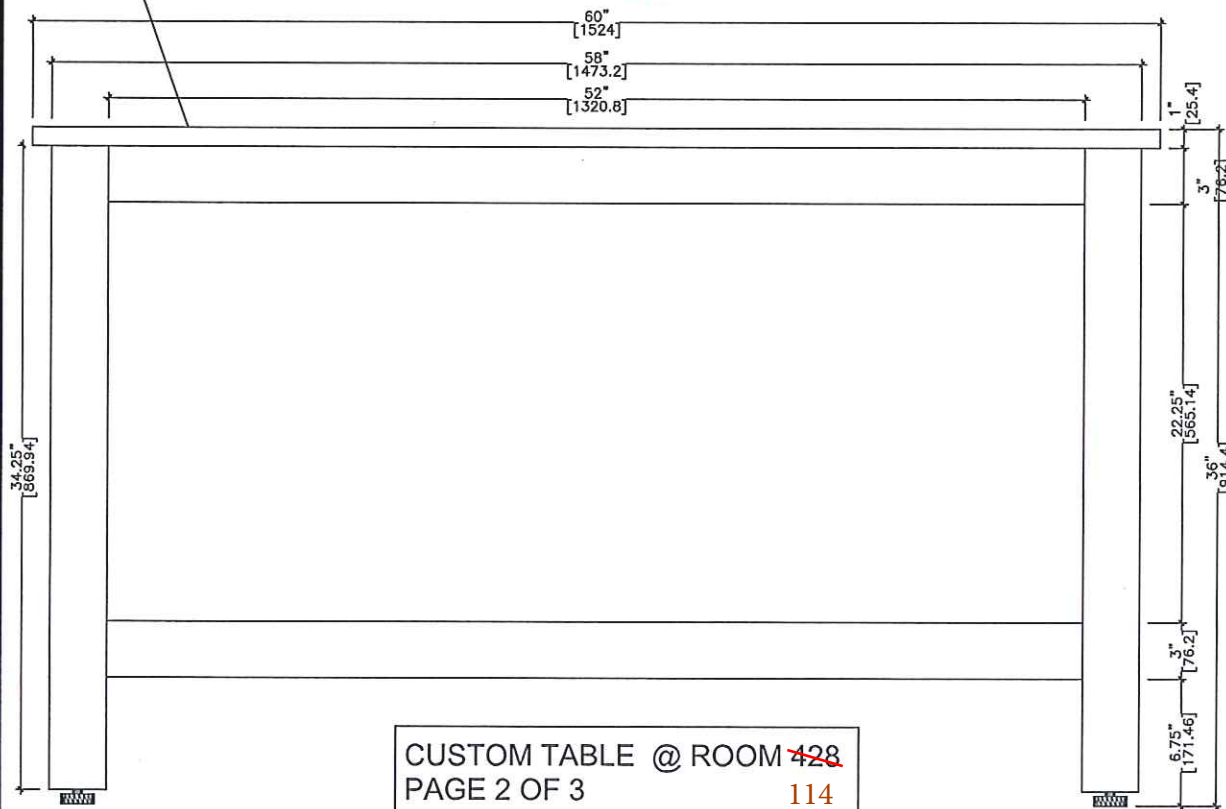


CUSTOM TABLE @ ROOM ~~428~~
PAGE 2 OF 3
114

FRONT VIEW

SIDE VIEW

PROJECT	SHEET TITLE
ISEC MSU COOLY	MID TABLES FRONT AND SIDE VIEW

DATE	SCALE	DRAWN BY	CONTRACT#
10/25/2012	1=4	J.T.W.	91-05??
MATERIAL	FINISH	REQUIRED:	SHEET
11 GA.	GLACIER BLUE	NOV15	2 of 3
			DWG#
			02

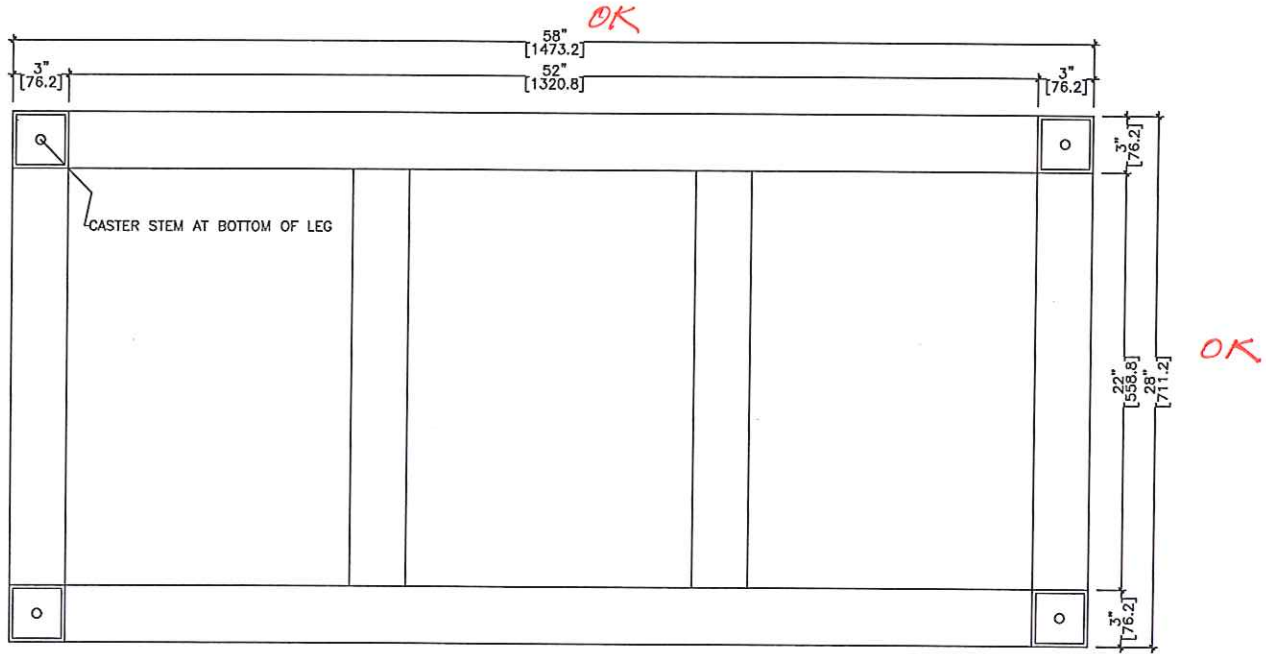

PLAN VIEW
 TOP REMOVED
 ROOM ~~428~~¹¹⁴ ALL CONNECTIONS ARE WELDED
 AND GROUND SMOOTH

CUSTOM TABLE @ ROOM ~~428~~
 PAGE 3 OF 3
 114

PROJECT
ISEC
 MSU COOLY

SHEET TITLE
 MED TABLES
 PLAN VIEW

DATE	10/25/2012	SCALE	1=4	DRAWN BY	J.T.W.	CONTRACT#	91-05??
MATERIAL	11 GA.	REQUIRED:		SHEET	3 of 3	DWG#	03
FINISH	GLACIER BLUE			NOV15			